


CHEFORNAK TRADITIONAL COUNCIL

WATER DISTRIBUTION SYSTEM IMPROVEMENTS


In Cooperation with the State of Alaska
Department of Environmental Conservation
Village Safe Water Program

AS-BUILT 9/30/98


ISSUED FOR CONSTRUCTION

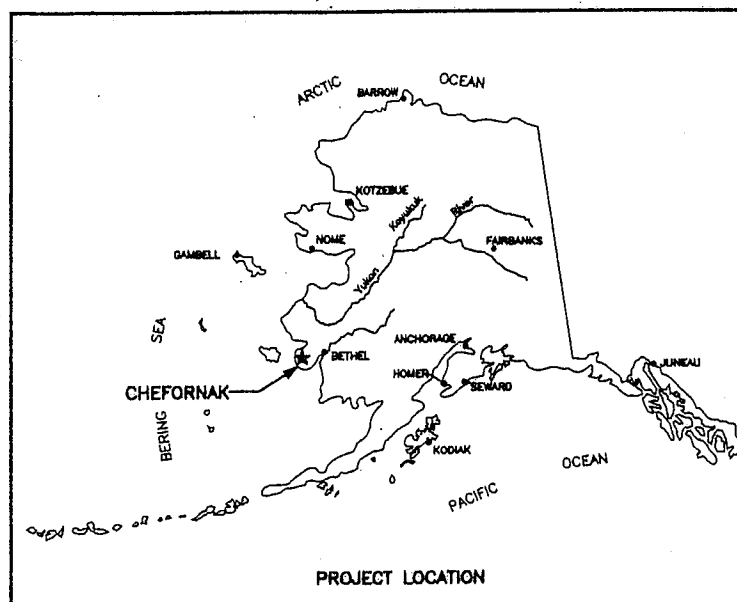



Location Map

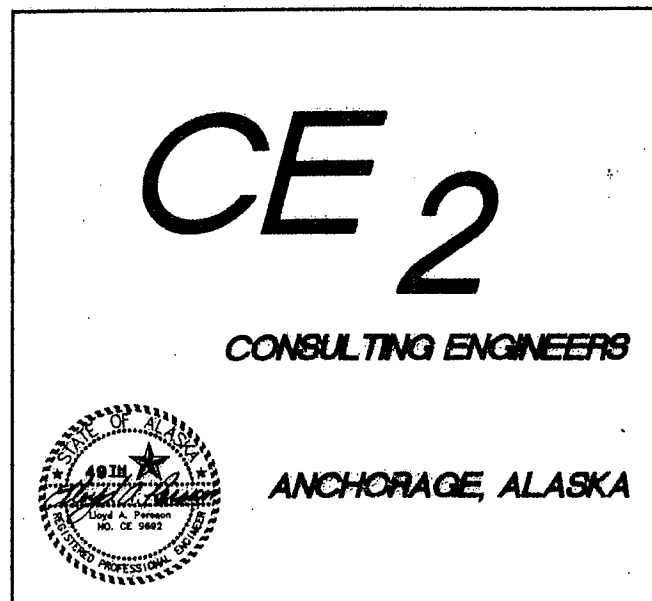

Consultant


RECORD DRAWING CERTIFICATE	
	THESE DRAWINGS REFLECT RECORDED INFORMATION OBTAINED DURING CONSTRUCTION. INFORMATION PROVIDED HEREIN IS ACCURATE TO THE BEST OF MY KNOWLEDGE.
<u>Lloyd A. Persson</u> NAME	<u>12/30/98</u> DATE
Construction Foreman <u>GARRY BOWLEY</u>	
Final Design (Date) <u>JULY 10, 1998</u>	
ADEC Approval (Date) <u>JULY 12, 1998</u>	
Construction Period (From) <u>SEP. 1, 1998</u> (To) <u>SEP. 28, 1998</u>	
As-Built (Date) <u>SEPTEMBER 30, 1998</u>	

SHEET INDEX	
No.	Title
	COVER SHEET AND DRAWING INDEX
G-1	WATERING POINT LOCATIONS
M-1	WATERING POINT MODIFICATIONS
E-WD-1	WATERING POINT MODIFICATIONS, ELECTRICAL

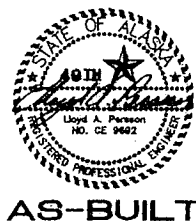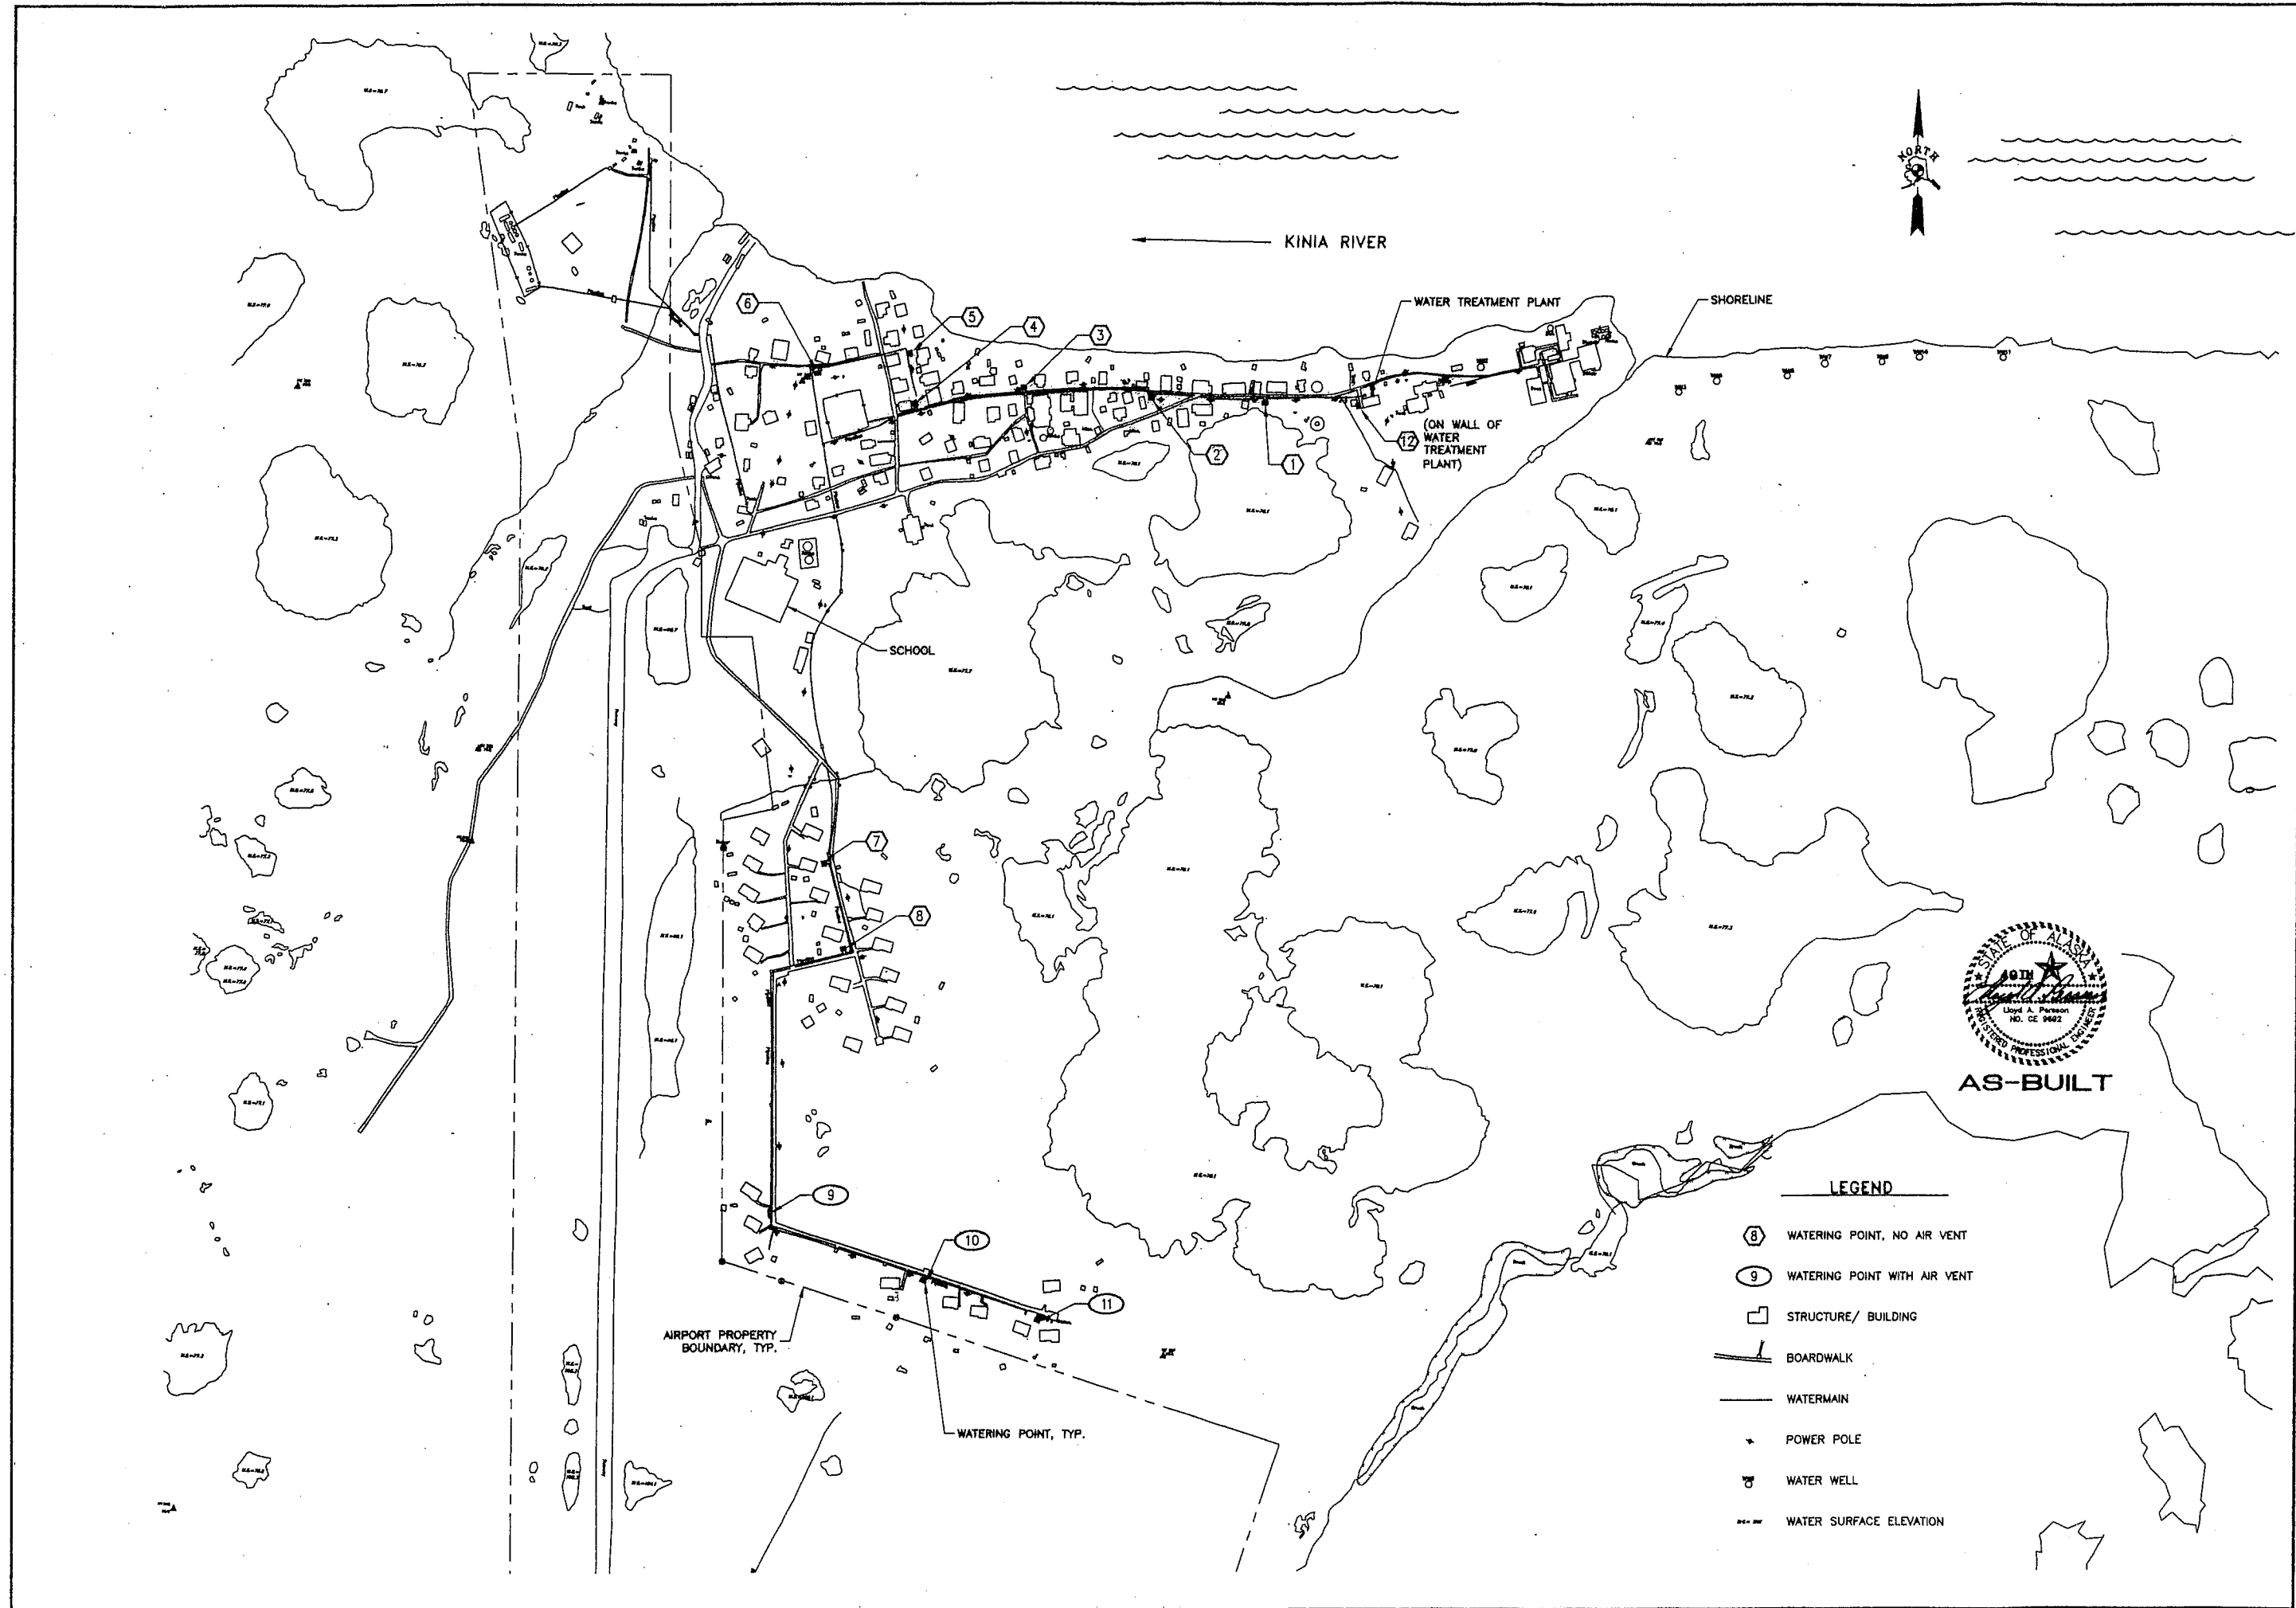


- LEGEND**
- (8) WATERING POINT, NO AIR VENT
 - (9) WATERING POINT WITH AIR VENT
 - [Square] STRUCTURE/ BUILDING
 - [Line with cross-ticks] BOARDWALK
 - [Solid line] WATERMAIN
 - [Star symbol] POWER POLE
 - [Circle with cross] WATER WELL
 - [Wavy line] WATER SURFACE ELEVATION

RECORD DRAWING CERTIFICATE	
THESE DRAWINGS REFLECT RECORDED INFORMATION OBTAINED DURING CONSTRUCTION. INFORMATION PROVIDED HEREIN IS ACCURATE TO THE BEST OF MY KNOWLEDGE.	
NAME	DATE
SCALE: 1" = 200'	
NOTES: SEE W-1 FOR EXISTING WATER MAINS. SEE W-2 FOR EXISTING WATER MAINS. SEE W-3 FOR EXISTING WATER MAINS.	
CONSTRUCTION RECORD	
FIELD BOOK	STAKING
FOREMAN	AS-BUILT
INSPECTOR	
WATER DISTRIBUTION SYSTEM IMPROVEMENTS	
WATERING POINT LOCATIONS	
CHEFORINAK, ALASKA	
CE2 ENGINEERS, INC.	
ANCHORAGE, ALASKA	
REVISION	BY DATE
ADDED AS-BUILT INFO	10/19/98
Project No.	1000
Date	JULY 1998
Designed	LAP
Drawn	D-J.W.
Approved	CLE
Sheet No. G-1	
SHEET 2 OF 4	

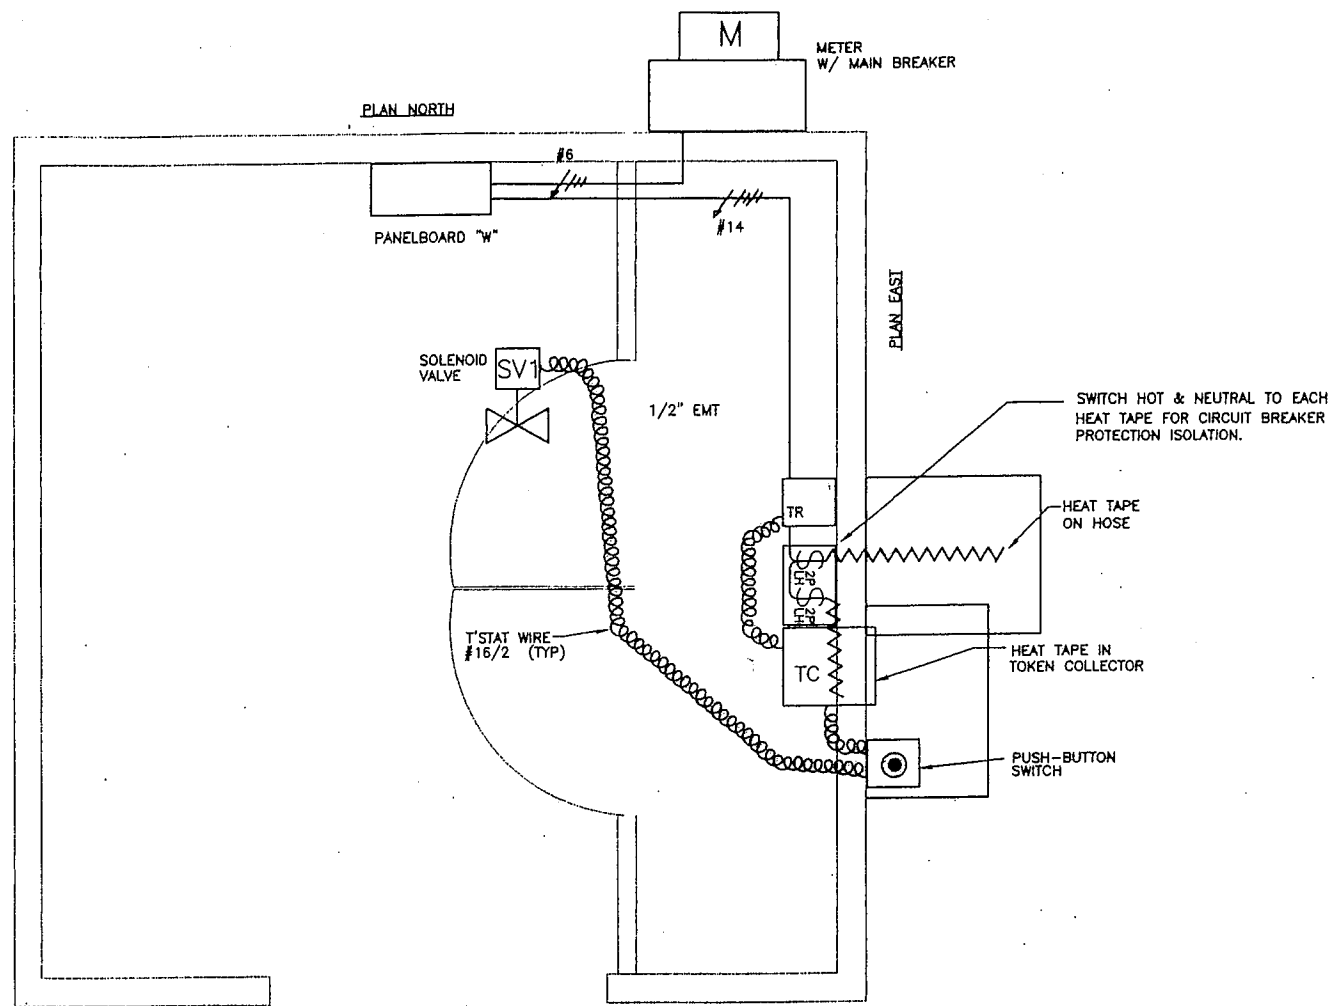


EQUIPMENT & CONTROLS PLAN


NOT TO SCALE

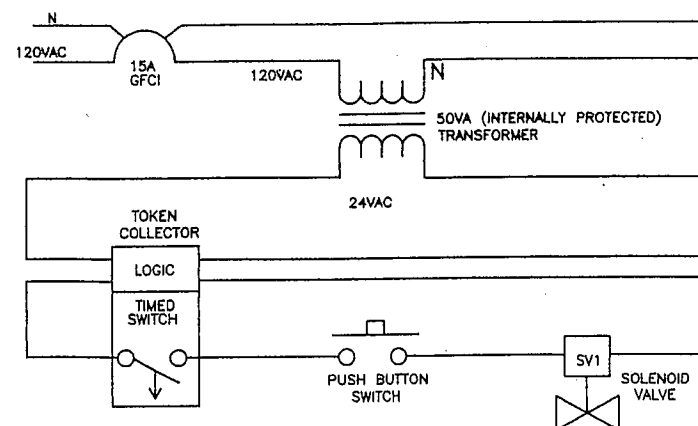

WATERING POINT WIRING PLANS

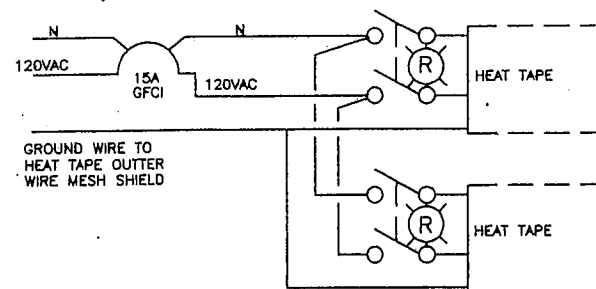


AS-BUILT

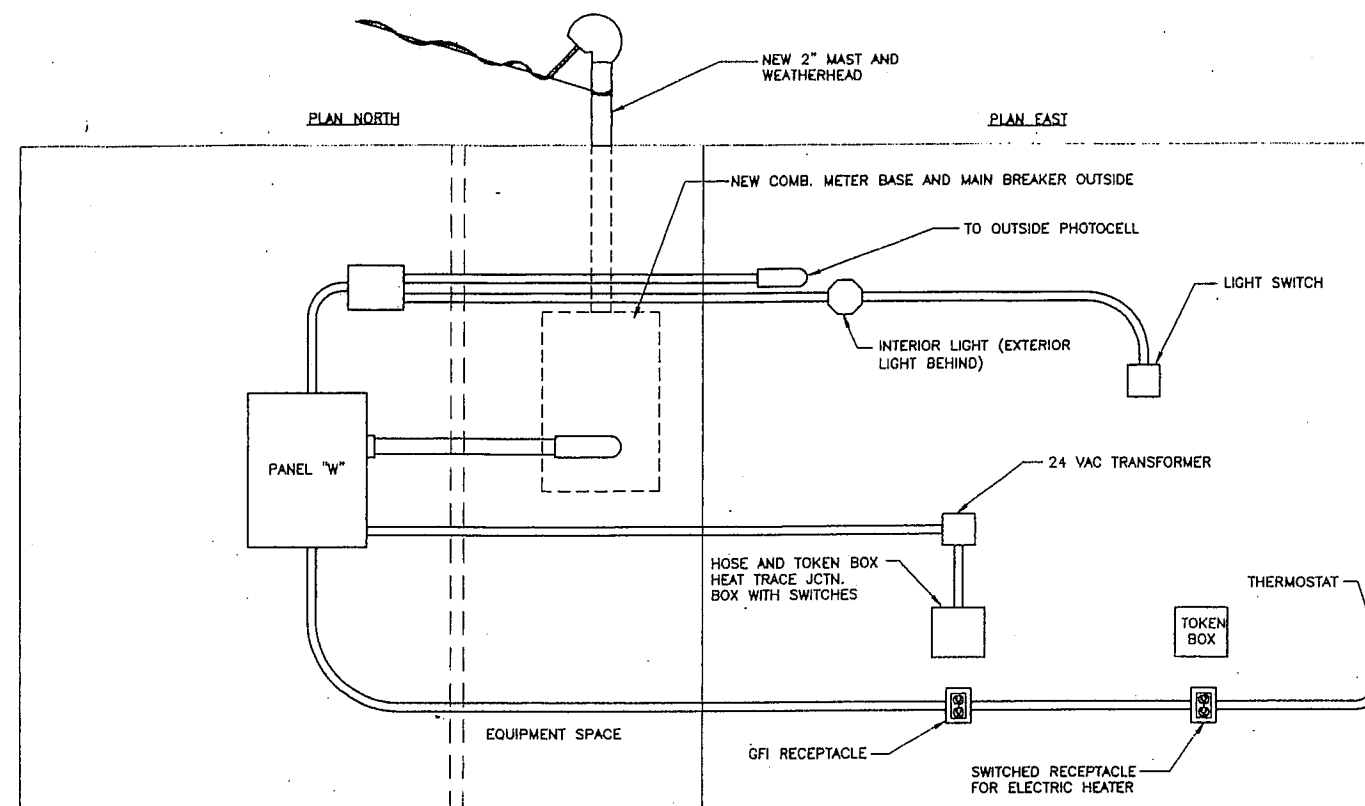

DEVICE LAYOUT - INTERIOR ELEVATION

NOT TO SCALE

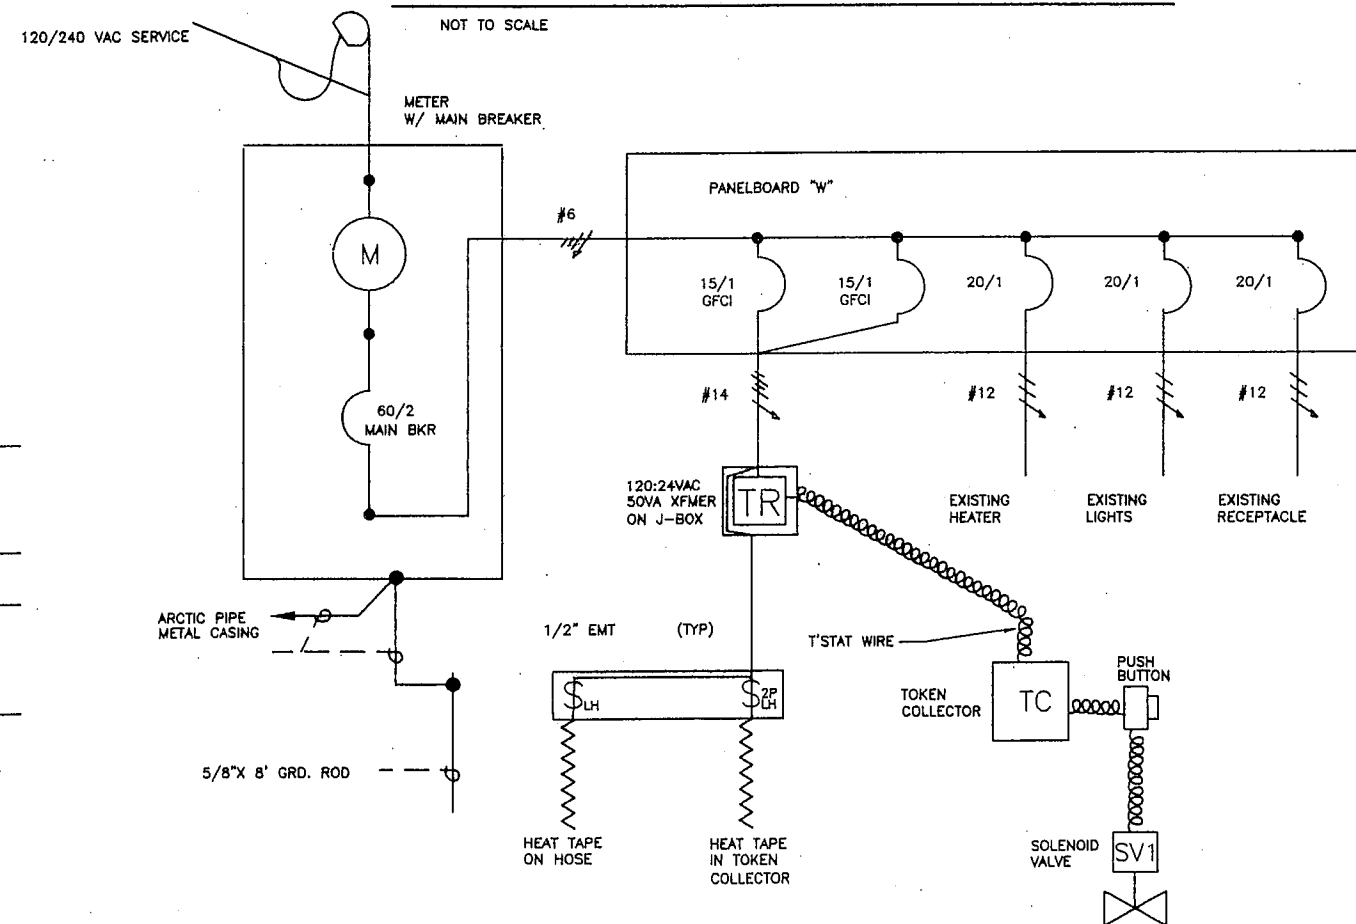


WATERING POINT BLDG POWER ONE-LINE

NOT TO SCALE

RECORD DRAWING CERTIFICATE
THESE DRAWINGS REFLECT
RECORDED INFORMATION OBTAINED
DURING CONSTRUCTION.
INFORMATION PROVIDED HEREIN
IS ACCURATE TO THE BEST OF
MY KNOWLEDGE.
DATE 05/20/98
NAME Lloyd A. Persson

SCALE:
AS SHOWN
1" = 1'

CONSTRUCTION RECORD
FIELD BOOK
STANDING
FORWARD
AS-BUILT
INSPECTION

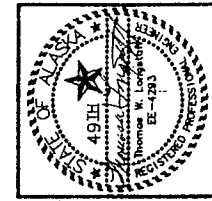

WATER DISTRIBUTION
SYSTEM IMPROVEMENTS
WATERING POINT
MODIFICATIONS,
ELECTRICAL
ANCHORAGE, ALASKA

CE2
ENGINEERS,
INC.
ANCHORAGE, ALASKA

REVISION
BY
DATE

Project No. 05/20/98
Date 05/20/98
Designed TWL
Drawn DAH
Approved TWL

Sheet No. E-WD-1
SHEET 4 OF 4